


GAS-MAP

Showing
THE PIPES AND THEIR DIAMETER IN INCHES
as laid down in Streets.

SCALE:
250 feet to the inch.

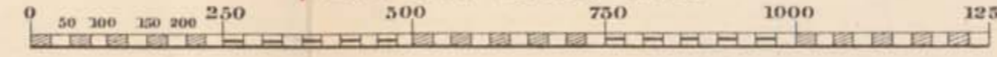

ALL PIPES
shown on this page
are respectively:

- 2 inches.
- 3 " "
- 4 " "
- 6 " "
- 8 " "
- 12 " "
- 16 " "
- 20 " "

