GAS-MAP

Showing

THE PIPES AND THEIR DIAMETER IN INCHES

as laid down in Streets.

ALL PIPES
shown on this page
are respectively:

2 inches.
3 "
4 "
6 "
8 "
12 "
16 "
20 "

SCALE:
250 feet to the inch.
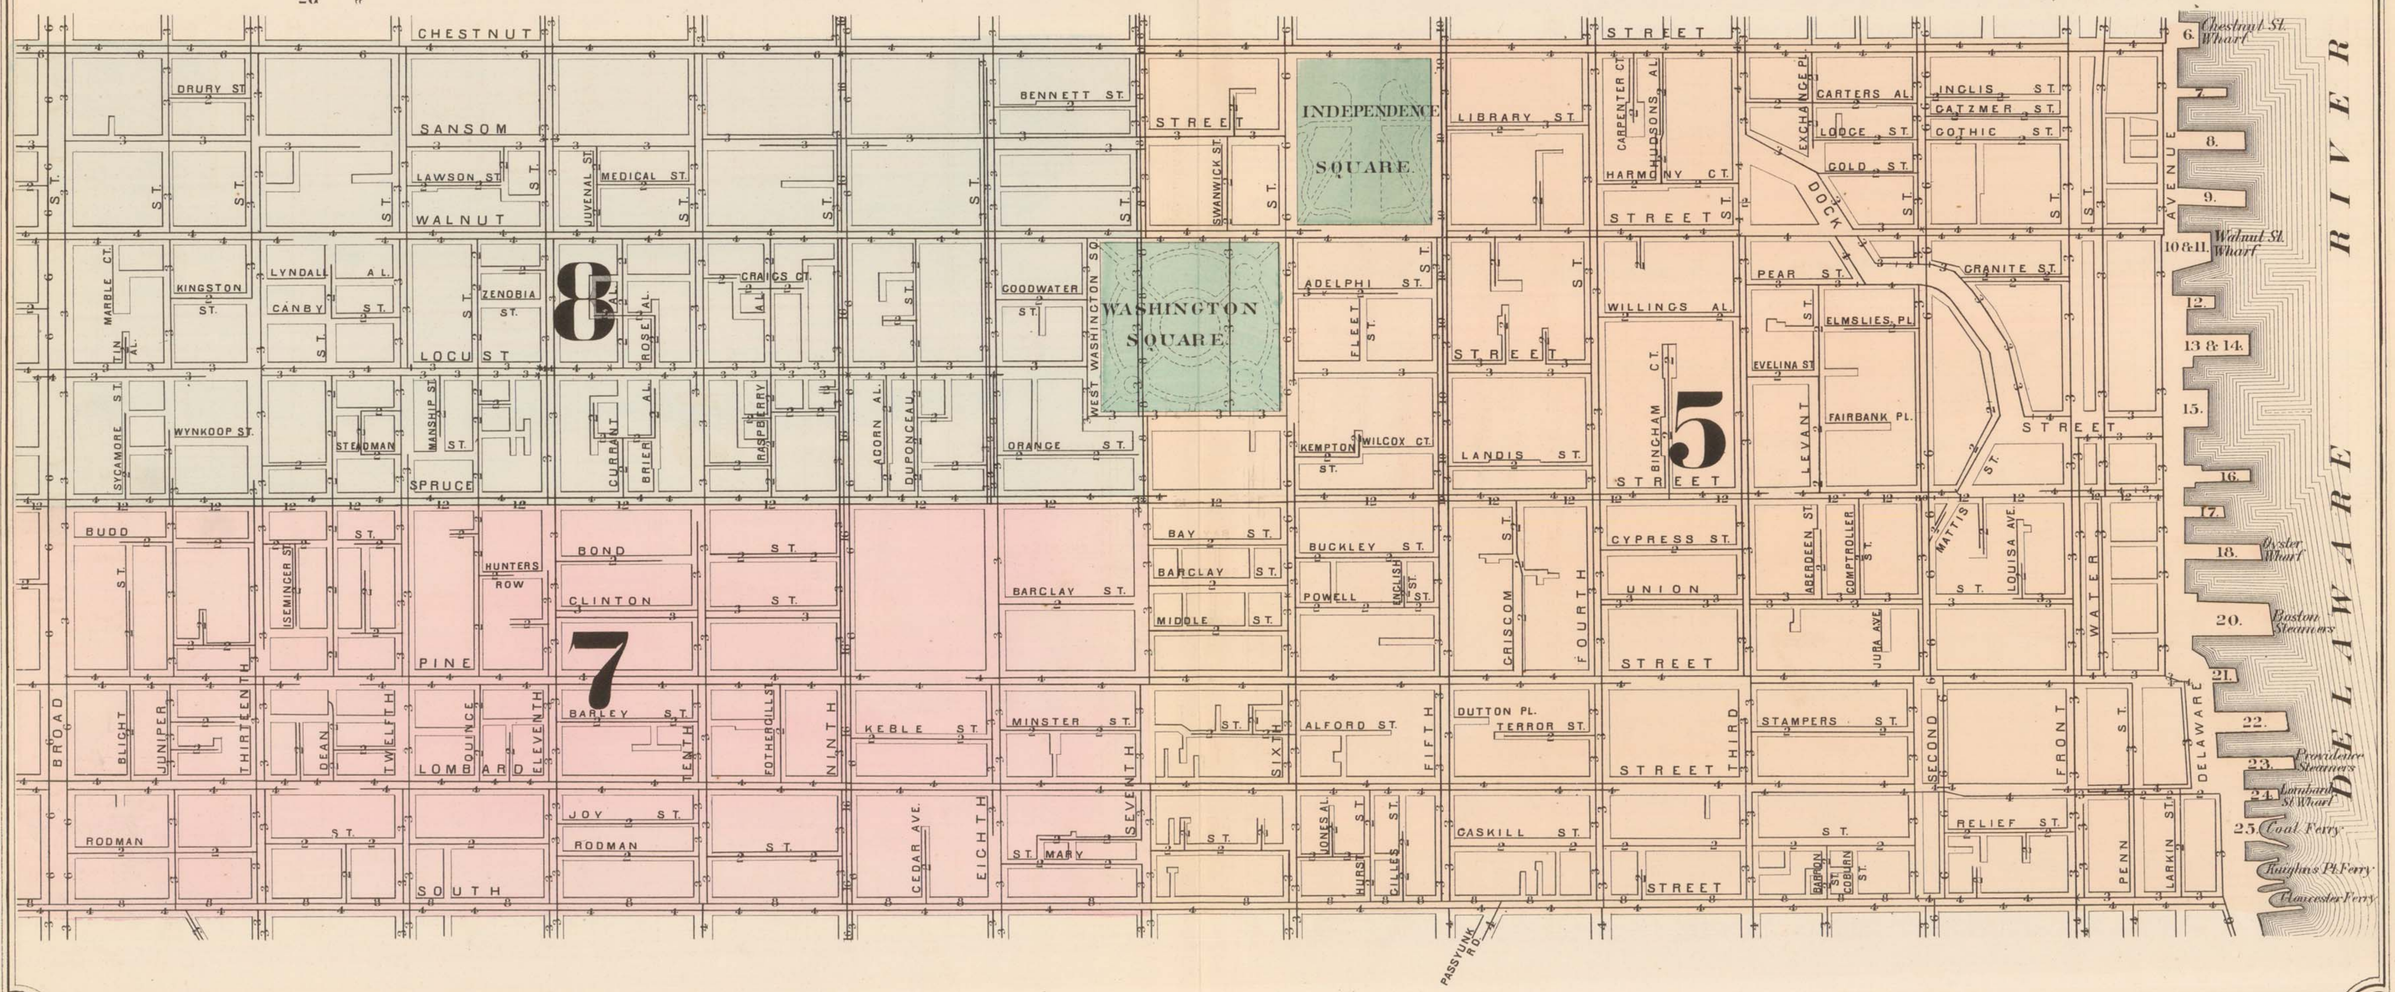
0 50 100 150 200 250 500 750 1000 1250